位置 LOCATION

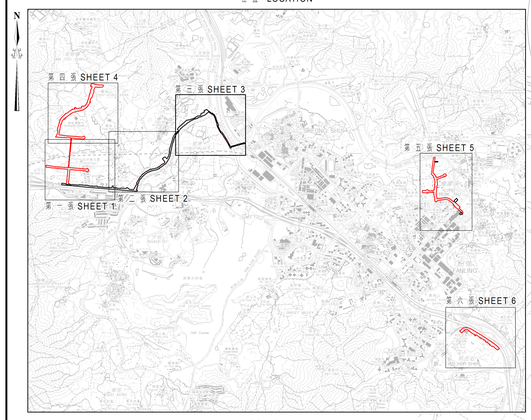

比例 SCALE 1:30 000

圖例
LEGEND

Pecked Red Line
- 施工範界線 LIMIT OF WORKS AREA
- 收地/清拆界線 RESUMPTION / CLEARANCE LIMIT
- 地段界線 LOT BOUNDARY
- D.D. 丈量約份 DEMARCATION DISTRICT
- G.L. 政府土地 GOVERNMENT LAND
- RP 餘段 REMAINING PORTION
- S. 分段 SECTION
- 丈量約份界線 DEMARCATION DISTRICT BOUNDARY
- Pecked Red Line - 紅色虛線 PECKED RED LINE

D.D. 95
D.D. 92
G.L.
1618
1617 RP
1601 RP
1588 S.B
1600 RP
1592 RP
1583 RP
1582 RP
1581
1579
1575
1345
1083
1049
1292 RP
1293
1289 RP
1288 RP
1287 RP
1286 RP
Pecked Red Line
SHEUNG YUE RIVER (RIVER BED)
LOCO RD
Sheung Shui Slaughter House
上水屠房
石湖墟污水處理廠
SHEK WU HUI SEWAGE TREATMENT WORKS
Filter Bed
於第二張圖中延續
TO BE CONTINUED ON SHEET 2

比例尺 SCALE 1:1 000
metres 20 0 20 40 60 80 100 metres

只作識別用
FOR IDENTIFICATION PURPOSES ONLY

Signed
(葉雪兒)(Joyce S.Y. NG)
總產業測量師(土地應用) Chief Estate Surveyor / Acquisition
日期 Date 14 NOV 2016

地政總署 工程項目組
Projects Section
Lands Department
奧祕自測繪處工程項目測量小組總監
Plan Prepared by Projects Survey Unit, Survey and Mapping Office

© 香港特別行政區政府 - 版權所有 Copyright reserved - Hong Kong SAR Government

修訂收地圖則

水污染管制（排污設備）規例（第358章附屬法例）第26條引用
道路（工程、使用及補償）條例（第370章）
工務計劃項目第7747CL號
古洞北新發展區及粉嶺北新發展區前期地盤平整和基礎設施工程（排污工程）

AMENDMENT RESUMPTION PLAN

ROADS (WORKS, USE AND COMPENSATION) ORDINANCE (CHAPTER 370)
AS APPLIED BY SECTION 26 OF THE WATER POLLUTION CONTROL (SEWERAGE) REGULATION (CHAPTER 358 SUBSIDIARY LEGISLATION)
PWP ITEM No. 7747CL
ADVANCE SITE FORMATION AND ENGINEERING INFRASTRUCTURE WORKS AT
KWU TUNG NORTH NEW DEVELOPMENT AREA AND FANLING NORTH NEW DEVELOPMENT AREA (SEWERAGE WORKS)

檔案編號 File No.	LD NDA/PLAN/3
測量圖編號 Survey Sheet No.	2-SE-5B, 5D & 3-SW-1C
工程圖編號 Engineering Drg. No.	6033557(6)(GZ)1400A, 401, 402, 403, 404, 405, 406, 407, 408A, 409A & 410A (土木工程拓展署) (CEDD)
圖則編號 PLAN No.	DNM5015a (第三張 共六張) (Sheet 3 of 6)

日期 Date : 14/11/2016